

TO ALL PLANHOLDERS OF RECORD.

RE: Request for Proposals (RFP) – Longview Pharmacy

FROM: Cari Clizbe, Programs Manager
cclizbe@cowlitz.org

PAGE(S): Ten (10), including this cover sheet.

DATE: June 12, 2026

Transmitted herewith is Addendum No. 2. If the Addendum is **not** received in full, please contact Cari Clizbe using contact information listed above. If all pages of the Addendum are received, please sign this sheet and include it in your bid package.

Company's Name

Company's Representative

Date

ADDENDUM NO. 2

June 12, 2026

Request for Quotations (RFP) –Longview Pharmacy

This document forms a part of and modifies the RFP as noted below. Offerors should acknowledge their receipt of this Addendum to the street address or email address listed below with your RFP submission package. Failure to do so may subject Offerors to disqualification.

FOR: Cowlitz Indian Tribe
Public Works Department
929 Fir Street
Longview, Washington 98462
Attention: Cari Clizbe
Email: cclizbe@cowlitz.org

The following corrections, clarifications and/or deletions to the RFP are hereby made a part of said documents.

This addendum consists of ten (10) pages.

ADDENDUM NO. 2

QUESTIONS AND ANSWERS

Please see attached drawings

Q. Should we submit certified payroll reports exclusively through the Washington State L&I online system, as is standard for state public works projects?

A. Yes

Q In addition to or instead of the state system, does this project specifically require the completion and submission of federal WH-347 forms directly to the Cowlitz Indian Tribe?

A. Yes

Q. Regarding subcontractor qualifications, will the Tribe require subcontractors to have a minimum number of years of documented experience with Washington State L&I contractor registration other than the L&I prevailing wage training completion?

A. No

Q. Should we submit a detailed list of experience and qualifications for each proposed subcontractor as part of our proposal, similar to the requirements for the prime contractor?

A. No

Q. To manage bidding risk, will the Tribe consider providing conditional approval of our proposed subcontractor list at the time of contract award, pending final documentation and reference checks?

A. The Tribe will not require a subcontractor list.

Q. The RFP and draft Lump Sum contract state payment will be made upon completion, with 5% retainage withheld. However, Section 2.3 of the contract also mentions 'each progress payment'. Could you please clarify if the prime will be able to submit monthly progress payments or will the prime need to wait until project completion for payment of the entire contract sum.

A. The contract will be a lump sum and the Tribe will allow monthly payments.

Q. Is there a sign-in sheet from the site walk held on 5/29 available?

A. No.

Q. Is there an estimated cost or budget for this project?

A. No

Q. Do you have an anticipated start date or completion date at this time?

A. ASAP

Q. Does this project have any union requirements?

A. This project is funded by Federal grants is required to follow Davis Beacon requirements.

Q. Plan sheet A201 references door # 107B whereas the Door Schedule on plan sheet A1001 does not show specifications for door # 107B. Please provide information as to the size and specifications for door #107B.

A. New door is 8'-0". The required header size and all connection details can be found on detail 3/S601.

Q. It appears that the existing door opening at door # 107B is being widened. If this is correct, please provide specifications and sizing for a new door header above this opening. Also, the exterior elevation will need to show siding infill above the door if the new door is not 8' tall (exterior elevations appear to show a 7'-0" tall door whereas the existing door at this location is currently 8' tall).

A. New door is 8'-0". The required header size and all connection details can be found on detail 3/S601.

Q. Has a Hazardous Building Materials Survey been completed for the existing building? If so, are you able to make the report available?

A. A Good Faith survey will be conducted before the project starts and will be shared with contractor.

Q. Plan sheet AD201 keynote 02.006 is referenced at two existing columns that are shown to remain. Structural Foundation Plan S201 appears to show these two columns receiving new footings. Is this a correct understanding of the plans?

A. See updated sheet AD201 in Addendum #2 for revised callouts.

Q. Plan sheet AD240 keynote 02.013 calls for the replacement of all existing roof batt insulation. Please specify what R-Value is required for the replacement insulation.

A. Provide R-49, Secure insulation with mechanical supports as required.

Q. Is cement board substrate required at Restroom wall tile locations?

A. Yes, per specification 09 21 16 2.02D

Q. Is abuse-resistant gypsum board required at new gypsum board ceiling locations?

A. Provide Gypsum Board at ceiling per specification 09 21 16 2.02E

Q. Please provide a paint color for the GWB ceilings as it does not appear to be designated on the plans.

A. See revised sheet A900 in Addendum #2 for paint color. Paint P-6 was added as SW 7007 Ceiling Bright White

Q. Is it acceptable to utilize metal stud framing at new interior walls in lieu of wood framing as shown on the plans?

A. We take no exceptions to utilizing metal studs for the interior walls as these are all not bearing partition walls.

Q. Sheet AD202.1-7 indicates the existing canopy and columns are to remain. However, Sheet AD202.9 includes the note: "Contractor to pressure wash and paint exterior, typ. Color to match existing." Can you please clarify which exterior items are intended to be repainted? For example: exterior walls, doors/frames, soffits, fascia, trim, downspouts, canopy, columns, or other exterior surfaces.

A. See sheet A101 for hatched area of work. Exterior Walls, Soffits, Fascia, Trim, Downspouts and other exterior surfaces to all be cleaned and painted. Canopy to be excluded.

Q. Specification Section 099000.C lists two acceptable topcoat systems for gypsum board walls: Sherwin-Williams ProMar 200 HP Zero VOC and Sherwin-Williams Scuff Tuff. Can you please confirm the preferred product and identify any specific locations where Scuff Tuff is required?

A. Delete Paragraph 09 90 00 2.04C 1B in its entirety.

Q. Is the architect going to manage submitting permits to the city? Or is the contractor expected to do so? Please verify that we should include building permit costs in our proposal.

A. Architect will manage the permits, and the owner will handle the costs.

Q. Do you have a good faith survey completed on the building? If so, can you share the results?

A. A Good Faith survey will be conducted before the project starts and will be shared with contractor.

Q. The finish schedule identifies AP-1 as Armstrong WoodWorks Grille "Classics Solid Wall Panel" in Red Oak on Poplar; however, I have not been able to locate any information in the plans or specifications regarding the slat depth, slat width, or spacing between the slats. As shown in the manufacturer's literature, there are several configurations available.

- A. • Panel width: 12-inch
- Panel Length: 96-inch
 - Item #: 7264BOGRK
 - o 12x96x1-7/8" (WxLxH); 5/8" W, 1-3/8" H, 8 slats with 7/8" slat spacing
 - Backer: Flexbacker for curved segments

All other terms and conditions of this RFP remain the same.

ADDENDUM # 2

Project Name: Cowlitz Indian Tribe Longview Pharmacy
Aetta Project #: 25065
Date: 06/10/2026

NOTICE TO BIDDERS:

The amendments and additions provided in this addendum shall become part of the Contract Documents for this Project. Bidder shall acknowledge receipt of this, and all other Addendum in the space provided on the Bid Form.

GENERAL INFORMATION / CLARIFICATION:

| Item # | Location/Section: | Description |
|---------------|--------------------------|--------------------|
| None | | |

ALL DRAWINGS:

1. Architectural

DRAWINGS:

| Item #: | Sheet/Detail: | Description: |
|----------------|----------------------|---|
| 1.02 | AD201 | REVISE sheet for column keynotes |
| 1.03 | A311 | ADDED metal attic hatch |
| 1.04 | A900 | ADDED paint color P-6 for gyp ceilings |
| 1.05 | A1001 | ADDED door #107B to door schedule |

SPECIFICATIONS:

| Item # | Section: | Description |
|---------------|-------------------|---|
| 1.06 | 09 90 00 2.04C 1B | REMOVE Paragraph in its entirety |

2. Structural (None)
3. Mechanical (None)
4. Plumbing (None)

Attachments:

DRAWINGS:

AD201, A311, A900, A1001


SPECIFICATIONS:

None

OTHER DOCUMENTS:

None

END OF ADDENDUM # 2

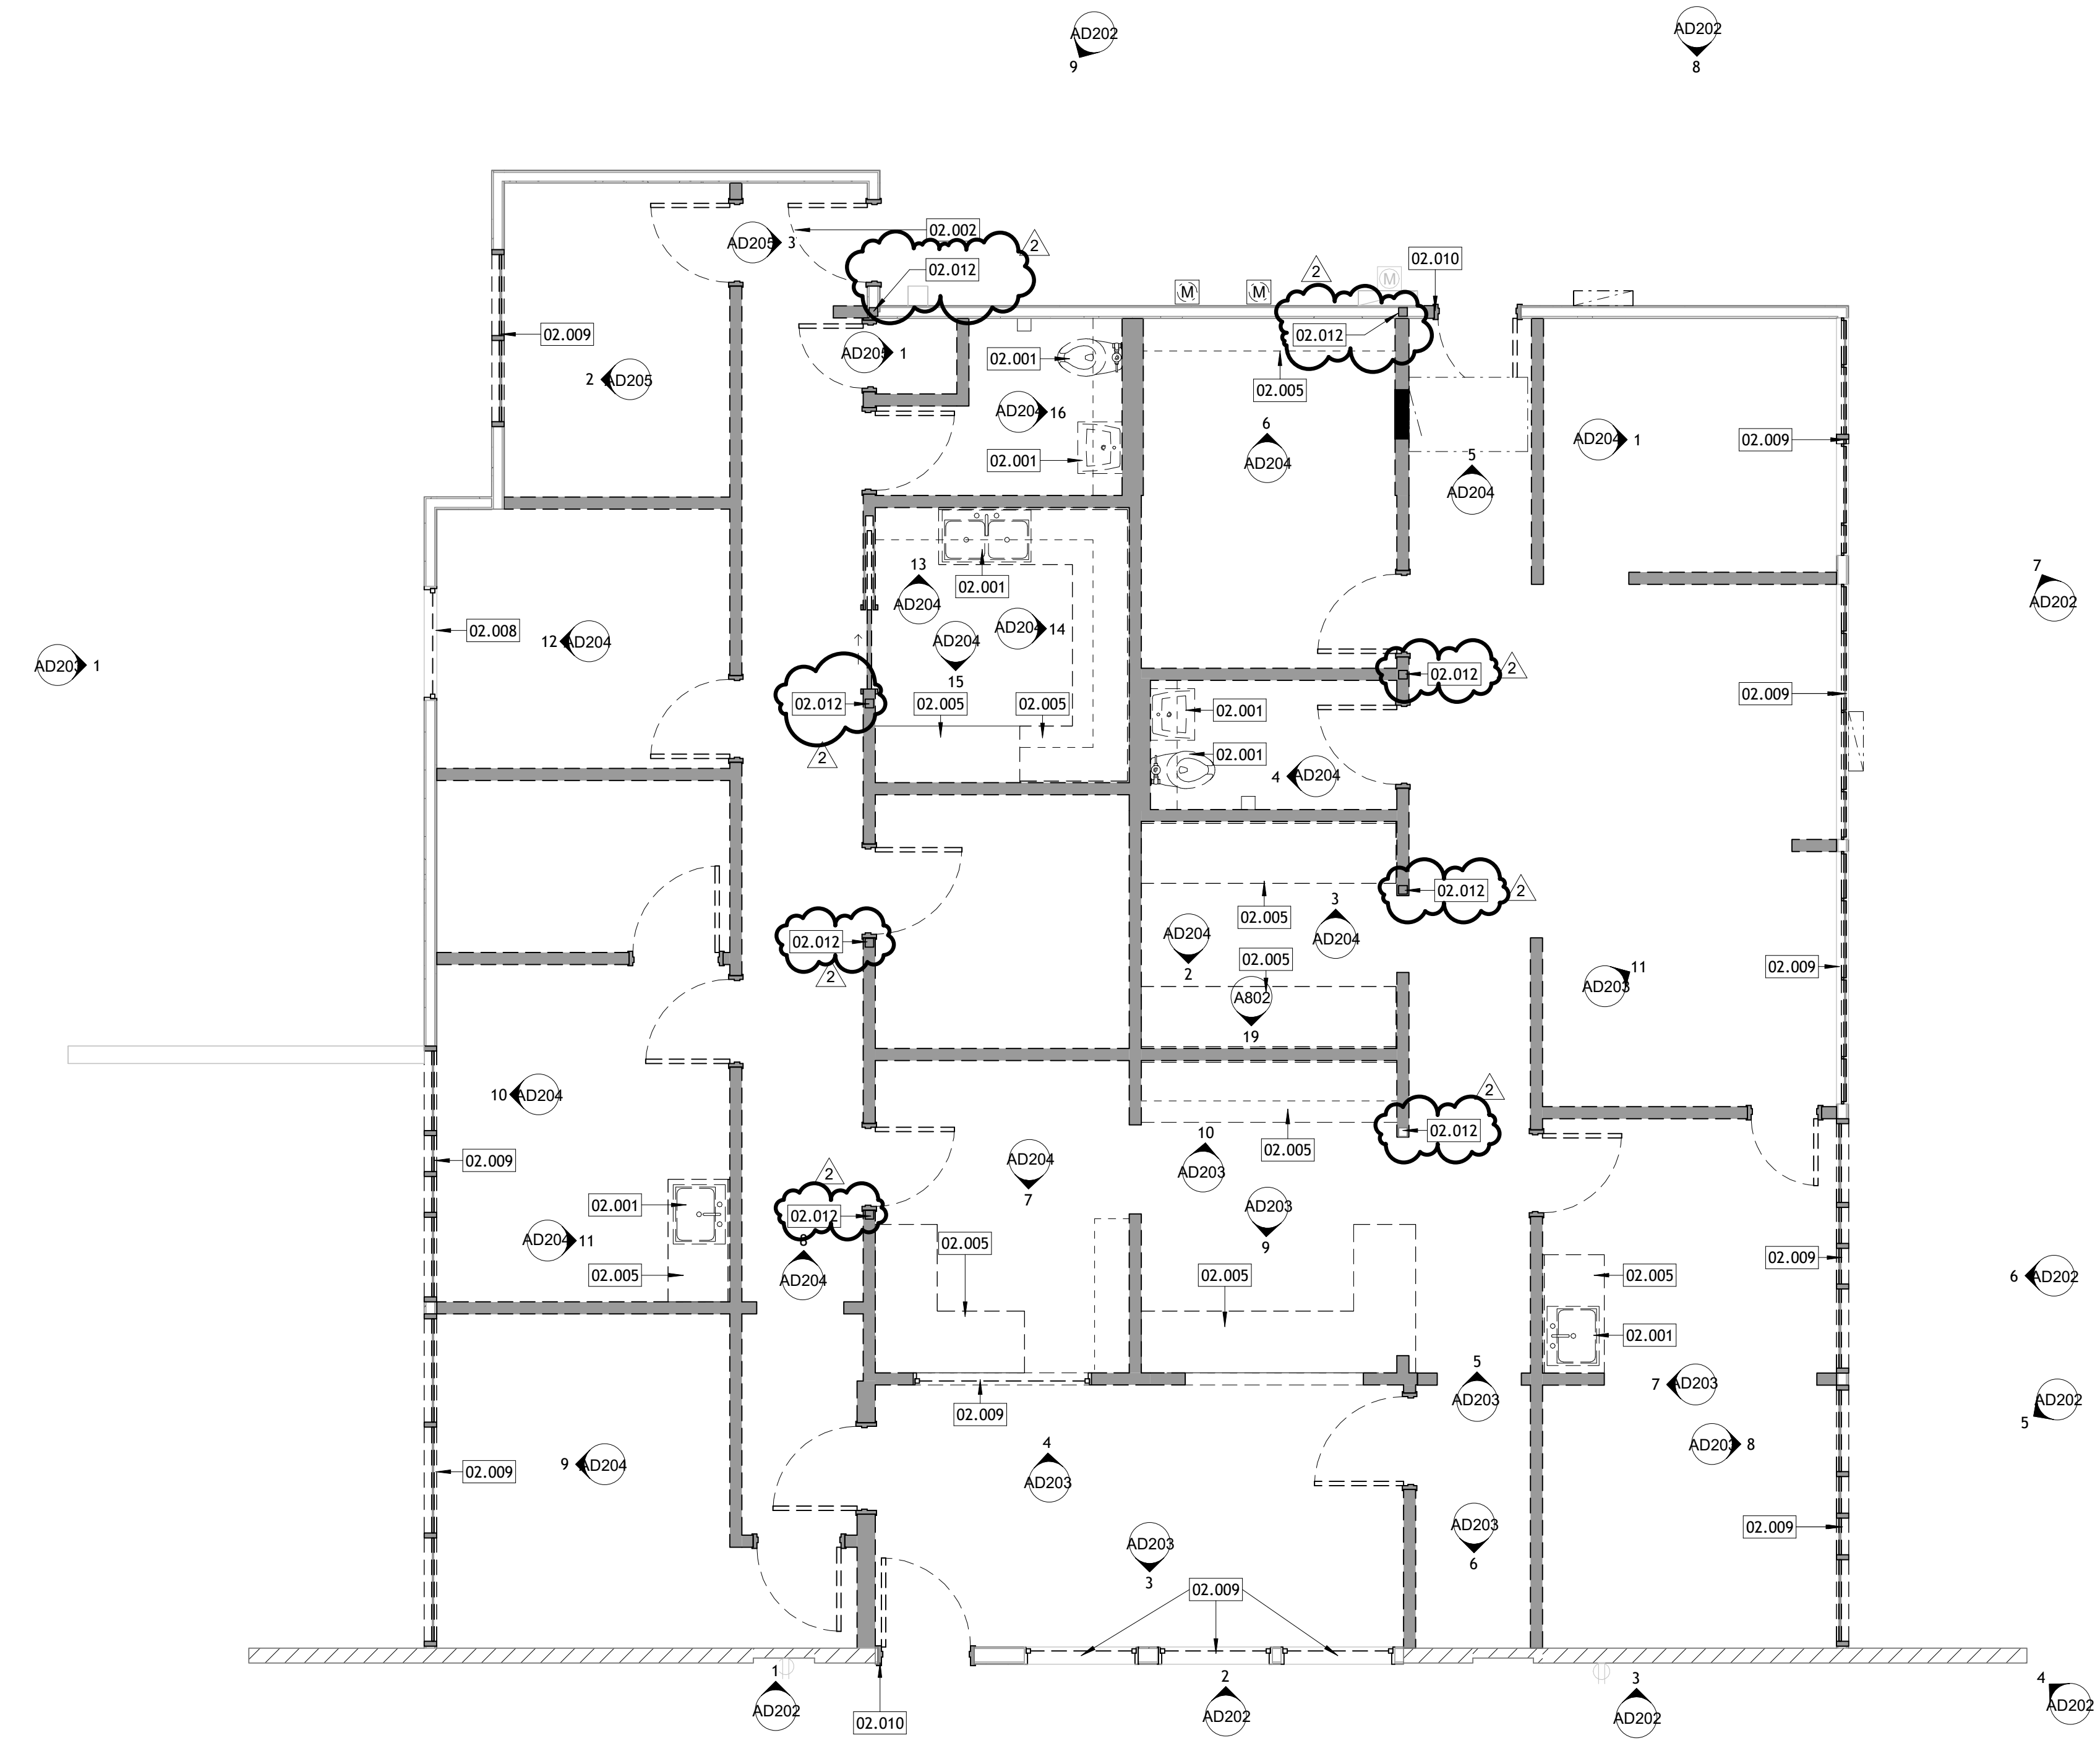

GENERAL NOTES:

1. DEMOLITION PLANS INDICATE DEMOLITION OF PRIMARY ARCHITECTURAL, STRUCTURAL, MECHANICAL, ELECTRICAL AND PLUMBING COMPONENTS AND MAY NOT SHOW ALL COMPONENTS. REFER TO ARCHITECTURAL, STRUCTURAL, MECHANICAL, ELECTRICAL AND PLUMBING FOR ADDITIONAL INFORMATION
2. REFER TO MECHANICAL PLANS FOR ADDITIONAL PLUMBING, HVAC, AND EQUIPMENT DEMOLITION
3. REFER TO ELECTRICAL PLANS FOR ADDITIONAL LIGHTING, POWER, AND SIGNALING DEMOLITION
4. ALL MECHANICAL, ELECTRICAL, AND PLUMBING DEMOLITION SHALL INCLUDE SYSTEM CAP-OFFS BACK TO THE SOURCE OR NEAREST JUNCTION BOX UNLESS OTHERWISE NOTED
5. PERFORM CUTTING TO ACCOMPLISH REMOVALS NEATLY AND AS REQUIRED FOR NEW WORK. REPAIR ADJACENT CONSTRUCTION AND FINISHES DAMAGED DURING REMOVAL WORK
6. PROTECT ALL EXISTING LANDSCAPING, WALLS, DOORS, AND FINISHES TO REMAIN DURING WORK
7. REMOVE AND DISPOSE OF ALL EXISTING TOILETS, SINKS, AND ACCESSORIES
8. REMOVE AND DISPOSE OF ALL EXISTING COUNTERTOP, SHELVING AND WORKSTATIONS
9. REMOVE AND DISPOSE OF EXISTING CEILING SYSTEM AS REQUIRED TO ACCOMMODATE WORK. PATCH AND REPAIR AS REQUIRED TO FACILITATE NEW LAYOUT
10. REMOVE AND DISPOSE OF ALL EXISTING ROOF BATT INSULATION
11. REMOVE AND DISPOSE OF ALL EXISTING DOORS, FRAMES, HARDWARE AND SIDE LITES
12. REMOVE AND DISPOSE OF ALL EXISTING SLIDING DOORS, FRAMES, HARDWARE AND RELATED ITEMS
13. REMOVE AND DISPOSE OF ALL EXISTING FLOOR COVERING AND ADHESIVE ON SLAB

DEMOLITION LEGEND:

- EXISTING WALLS TO REMAIN
- REMOVE AND DISPOSE WALLS
- REMOVE AND DISPOSE DOOR AND FRAME

KEYNOTE LEGEND

| | |
|--------|--|
| 02.001 | REMOVE AND DISPOSE OF FIXTURE |
| 02.002 | REMOVE AND DISPOSE OF DOOR |
| 02.005 | REMOVE AND DISPOSE OF CASEWORK IN ITS ENTIRETY |
| 02.008 | EXISTING WINDOW TO BE DEMOLISHED |
| 02.009 | REMOVE AND DISPOSE OF EXISTING WINDOW |
| 02.010 | DEMOLISH PORTION OF EXISTING EXTERIOR WALL TO ACCOMMODATE NEW DOOR |
| 02.012 | EXISTING COLUMN TO BE DEMOLISHED |

1 EXISTING/DEMOLITION FLOOR PLAN
 1/4" = 1'-0"

**COWLITZ INDIAN TRIBE
 LONGVIEW PHARMACY**
 1010 FIR STREET
 LONGVIEW, WA 98632

PROJECT # 25065
 DATE 05.19.2026

| REVISIONS | | |
|-----------|-----------|-------------|
| NO. | DATE | DESCRIPTION |
| 2 | 6.10.2026 | REV 2 |

DEMO FLOOR PLAN

AD201

BID SET


| FINISH SCHEDULE | | | | | | | | | |
|-----------------|-----------------------|--------------|------|-------------------|------------------|-------------------|------------------|-------------------|----------------|
| Room # | Name | Floor Finish | Base | Wall Finishes | | | | Ceiling Finish | Comments |
| | | | | North Wall Finish | East Wall Finish | South Wall Finish | West Wall Finish | | |
| 100 | WAITING / RETAIL AREA | SV-1/WOM-1 | B-2 | AP-1 | AP-1 | P-1 | P-1 | GWB (P-6) / ACT-1 | |
| 102 | PUBLIC RESTROOM | SV-3 | B-4 | T-2 | T-2 | T-1/P-1 | T-1/P-1 | GWB (P-6) | |
| 103 | CONSULTATION ROOM | SV-1 | B-2 | P-3 | P-1 | P-1 | P-1 | GWB (P-6) / ACT-1 | |
| 104 | PHARMACY | SV-2 | B-3 | P-3/P-1 | P-1 | P-1 | P-1,P-2 | GWB (P-6) / ACT-1 | SEE ELEVATIONS |
| 105 | STORAGE | SV-2 | B-3 | P-1 | P-1 | P-1 | P-1 | GWB (P-6) / ACT-1 | |
| 106 | OFFICE | LVT-1 | B-1 | P-1 | P-1 | P-1 | P-1 | GWB (P-6) / ACT-1 | |
| 107 | HALL | WOM-1/LVT-1 | B-1 | P-1 | P-1 | P-1 | - | GWB (P-6) / ACT-1 | |
| 108 | STAFF RESTROOM | SV-3 | B-4 | T-1/P-1 | T-2 | T-1/P-1 | T-1/P-1 | GWB (P-6) | SEE ELEVATIONS |
| 109 | JANITOR | SV-3 | B-4 | P-1 | P-1 | P-1/FRP-1 | P-1/FRP-1 | GWB (P-6) | SEE ELEVATIONS |
| 110 | ITELECT. | SV-2 | B-3 | P-1 | P-1 | P-1 | P-1 | GWB (P-6) | |
| 111 | BREAKROOM | LVT-1 | B-1 | P-1 | P-1 | P-1 | P-1 | GWB (P-6) / ACT-1 | |

72

| SHEET VINYL | | TILE | | ACOUSTICAL CEILING TILE | | PAINT | | | | | | | | | | | | | |
|----------------------------|--|------------------------------|---|-------------------------|--|---|--|--------------|--------------|--------------------------|--------------|------------------------|------------------|-------------------|--------------------|----------------------------|------------------|---------------------------|--------------------|
| SV-1 | DESC: HETEROGENEOUS SHEET MFR: MANNINGTON COLOR: LEAD WHITE | T-1 | DESC: TYPICAL MFR: SHAW CONTRACT COLLECTION: INTERACT SIZE: 4'X8" COLOR: 00100 FROST GROUT: - INSTALL: VERTICAL | ACT-1 | DESC: GLUE UP TILE MFR: ARMSTRONG COLLECTION: TECTUM STYLE: DIRECT ATTACH SIZE: 2X2 COLOR: WHITE | P-1 | MFR: SHERWIN WILLIAMS COLOR: SW 7551 GREEK VILLA | | | | | | | | | | | | |
| SV-2 | DESC: SD SHEET VINYL MFR: FORBO COLOR: MORTAR | T-2 | DESC: ACCENT MFR: SHAW CONTRACT COLLECTION: INTERACT SIZE: 4'X8" COLOR: 00415 BAY GROUT: - INSTALL: VERTICAL | | | P-2 | MFR: SHERWIN WILLIAMS COLOR: SW7036 ACCESSIBLE BEIGE | | | | | | | | | | | | |
| SV-3 | DESC: HOMOGENEOUS SLIP RESISTANT MFR: MANNINGTON SIZE: 6'-6" COLOR: ICECAP | | | | | P-3 | MFR: SHERWIN WILLIAMS COLOR: SW9148 SMOKY AZURITE | | | | | | | | | | | | |
| | | | | | | P-4 | MFR: SHERWIN WILLIAMS COLOR: SW 7019 GAUNTLET GRAY | | | | | | | | | | | | |
| | | | | | | P-5 | MFR: SHERWIN WILLIAMS COLOR: SW 6990 CAVIAR | | | | | | | | | | | | |
| | | | | | | P-6 | MFR: SHERWIN WILLIAMS COLOR: SW 7007 CEILING BRIGHT WHITE | | | | | | | | | | | | |
| LUXURY VINYL TILE | | FIBERGLASS REINFORCED PANELS | | WINDOW ROLLER SHADE | | PAINT SHEEN LEGEND | | | | | | | | | | | | | |
| LVT-1 | MFR: MOHAWK STYLE: SECOYA 5.0 COLOR: 821 CHAI OAK | FRP-1 | MFR: MARLITE PRODUCT: PEBBLED FRP COLOR: P 199 BRIGHT WHITE | WRS-1 | DESC: DUAL ROLLER MANUAL SHADE MFR: DRAPER PRODUCT: FLEXSHADE ELEVATE SHADES: SHEERWEAVE INFINITY 2 SIZE: WINDOW DEPENDENT, MEASURE COLOR: VG4 SLATE OPACITY: 5% OPENNESS & 1% OPENNESS NOTES: CORDLESS | <table border="1"> <thead> <tr> <th>SURFACE TYPE</th> <th>PAINT FINISH</th> </tr> </thead> <tbody> <tr> <td>GYPSUM WALLBOARD CEILING</td> <td>FLAT ACRYLIC</td> </tr> <tr> <td>GYPSUM WALLBOARD WALLS</td> <td>EGGSHELL ACRYLIC</td> </tr> <tr> <td>PAINTED WOOD TRIM</td> <td>SEMI-GLOSS ACRYLIC</td> </tr> <tr> <td>PAINTED METAL DOORS/FRAMES</td> <td>SEMI-GLOSS ALKYD</td> </tr> <tr> <td>PAINTED WOOD DOORS/FRAMES</td> <td>SEMI-GLOSS ACRYLIC</td> </tr> </tbody> </table> | | SURFACE TYPE | PAINT FINISH | GYPSUM WALLBOARD CEILING | FLAT ACRYLIC | GYPSUM WALLBOARD WALLS | EGGSHELL ACRYLIC | PAINTED WOOD TRIM | SEMI-GLOSS ACRYLIC | PAINTED METAL DOORS/FRAMES | SEMI-GLOSS ALKYD | PAINTED WOOD DOORS/FRAMES | SEMI-GLOSS ACRYLIC |
| SURFACE TYPE | PAINT FINISH | | | | | | | | | | | | | | | | | | |
| GYPSUM WALLBOARD CEILING | FLAT ACRYLIC | | | | | | | | | | | | | | | | | | |
| GYPSUM WALLBOARD WALLS | EGGSHELL ACRYLIC | | | | | | | | | | | | | | | | | | |
| PAINTED WOOD TRIM | SEMI-GLOSS ACRYLIC | | | | | | | | | | | | | | | | | | |
| PAINTED METAL DOORS/FRAMES | SEMI-GLOSS ALKYD | | | | | | | | | | | | | | | | | | |
| PAINTED WOOD DOORS/FRAMES | SEMI-GLOSS ACRYLIC | | | | | | | | | | | | | | | | | | |
| WALK-OFF MAT | | PLASTIC LAMINATE | | CORNER GUARDS | | NOTES 1. REFER TO SCHEDULE, FINISH PLANS, CEILING PLANS, AND INTERIOR ELEVATIONS FOR MATERIAL LOCATIONS AND EXTENTS | | | | | | | | | | | | | |
| WOM-1 | MFR: PATCRAFT COLOR: 00500 - STERLING INSTALL: QUARTER TURN | PL-1 | MFR: FORMICA COLOR: 5883-58 PECAN WOODLINE FINISH: MATTE | CG-1 | MFR: INPRO PRODUCT: SURFACE MOUNT SIZE: 1 1/2" COLOR: STAINLESS STEEL | | | | | | | | | | | | | | |
| BASE | | SOLID SURFACE | | | | | | | | | | | | | | | | | |
| B-1 | DESC: RUBBER BASE MFR: TARKETT STYLE: BASEWORKS SIZE: 4" COLOR: 29 MOON ROCK WG | SS-1 | MFR: WILSONART COLOR: MORNING ICE LOCATION: ALL COUNTERS EDGE: EASED | | | | | | | | | | | | | | | | |
| B-2 | DESC: COVED SHEET VINYL MFR: MANNINGTON STYLE: PETROGLYPH SIZE: 6" COLOR: SANCTUM 5300 | ACOUSTICAL PANEL | | | | | | | | | | | | | | | | | |
| B-3 | DESC: COVED SHEET VINYL MFR: MANNINGTON STYLE: 550018 SIZE: 6" COLOR: MORTAR | AP-1 | MFR: ARMSTRONG PRODUCT: WOODWORKS GRILLE STYLE: CLASSICS SOLID WALL PANEL COLOR: RED OAK ON POPLAR | | | | | | | | | | | | | | | | |
| B-4 | DESC: COVED SHEET VINYL MFR: MANNINGTON STYLE: 6" COLOR: ICECAP | | | | | | | | | | | | | | | | | | |



950 12th Avenue Suite 200
Longview, WA 98632
PH: 360-425-0000
www.aetta.com

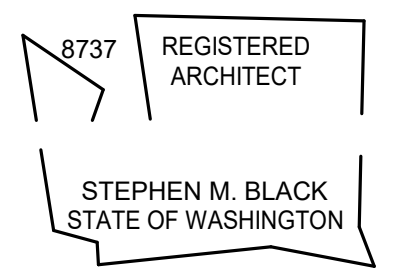

**COWLITZ INDIAN TRIBE
LONGVIEW PHARMACY**
1010 FIR STREET
LONGVIEW, WA 98632

PROJECT # 25065
DATE 05.19.2026
REVISIONS
NO. DATE DESCRIPTION
2 6.10.2026 REV 2

FINISH LEGEND/
SCHEDULE


A900

BID SET

| DOOR SCHEDULE | | | | | | | | | | |
|---------------|-------|--------|-----------|-----------|---------------|-------------|------------|----------------|--------------|--|
| Mark | Width | Height | Thickness | Door Type | Door Material | Door Finish | Frame Type | Frame Material | Frame Finish | Remarks |
| 100 | 3'-0" | 8'-0" | 1 3/4" | B | MTL | P-4 | A | HM | P-4 | CARD READER ACCESS CONTROL |
| 102 | 3'-0" | 7'-0" | 1 3/4" | A | WD | ST | A | HM | P-4 | PRIVACY LOCK |
| 103 | 3'-0" | 7'-0" | 1 3/4" | B | WD | ST | B | HM | P-4 | PASSAGE LOCKSET |
| 104 | 3'-0" | 7'-0" | 1 3/4" | B | WD | ST | B | HM | P-4 | CARD READER ACCESS CONTROL FROM BOTH SIDES OF DOOR |
| 104A | 4'-1" | 4'-6" | 0" | D | MTL | MFR | - | MTL | MFR | COILING DOOR |
| 104B | 4'-1" | 4'-6" | 0" | D | MTL | MFR | - | MTL | MFR | COILING DOOR |
| 105 | 3'-0" | 7'-0" | 1 3/4" | A | WD | ST | A | HM | P-4 | CARD READER ACCESS CONTROL |
| 106 | 3'-0" | 7'-0" | 1 3/4" | C | WD | ST | A | HM | P-4 | PASSAGE LOCKSET |
| 107 | 3'-0" | 7'-0" | 1 3/4" | C | WD | ST | A | HM | P-4 | CARD READER ACCESS CONTROL |
| 107B | 3'-0" | 8'-0" | 1 3/4" | A | MTL | P-4 | A | HM | P-4 | CARD READER ACCESS CONTROL |
| 108 | 3'-0" | 7'-0" | 1 3/4" | A | WD | ST | A | HM | P-4 | PRIVACY LOCK |
| 109 | 3'-0" | 7'-0" | 1 3/4" | A | WD | ST | A | HM | P-4 | STOREROOM LOCKSET |
| 110 | 3'-0" | 7'-0" | 1 3/4" | A | WD | ST | A | HM | P-4 | CARD READER ACCESS CONTROL |


GENERAL NOTES

- UNDERCUT ALL STANDARD INTERIOR DOORS TO CLEAR FLOOR BY 1/4".
- FURNISH (3) SILENCERS FOR SINGLE ACTING DOORS. DO NOT FURNISH SILENCERS FOR DOORS WITH WEATHERSTRIPPING, SEALS, OR GASKETS.
- PROVIDE SIGN AT MAIN EXIT DOOR PER IBC 1008.1.9.3, 2.2 STATING "THIS DOOR TO REMAIN UNLOCKED WHEN THE BUILDING IS OCCUPIED"
- COORDINATE DOOR HARDWARE MOUNTING HEIGHTS WITH VISION PANELS
- SEAL ALL WINDOW AND DOOR ASSEMBLIES TO PREVENT BUILDING ENVELOPE AIR LEAKAGE PER REQUIREMENTS OF AAMA/WDMA/CSA 1011.S.2/A440 OR NFRC 400

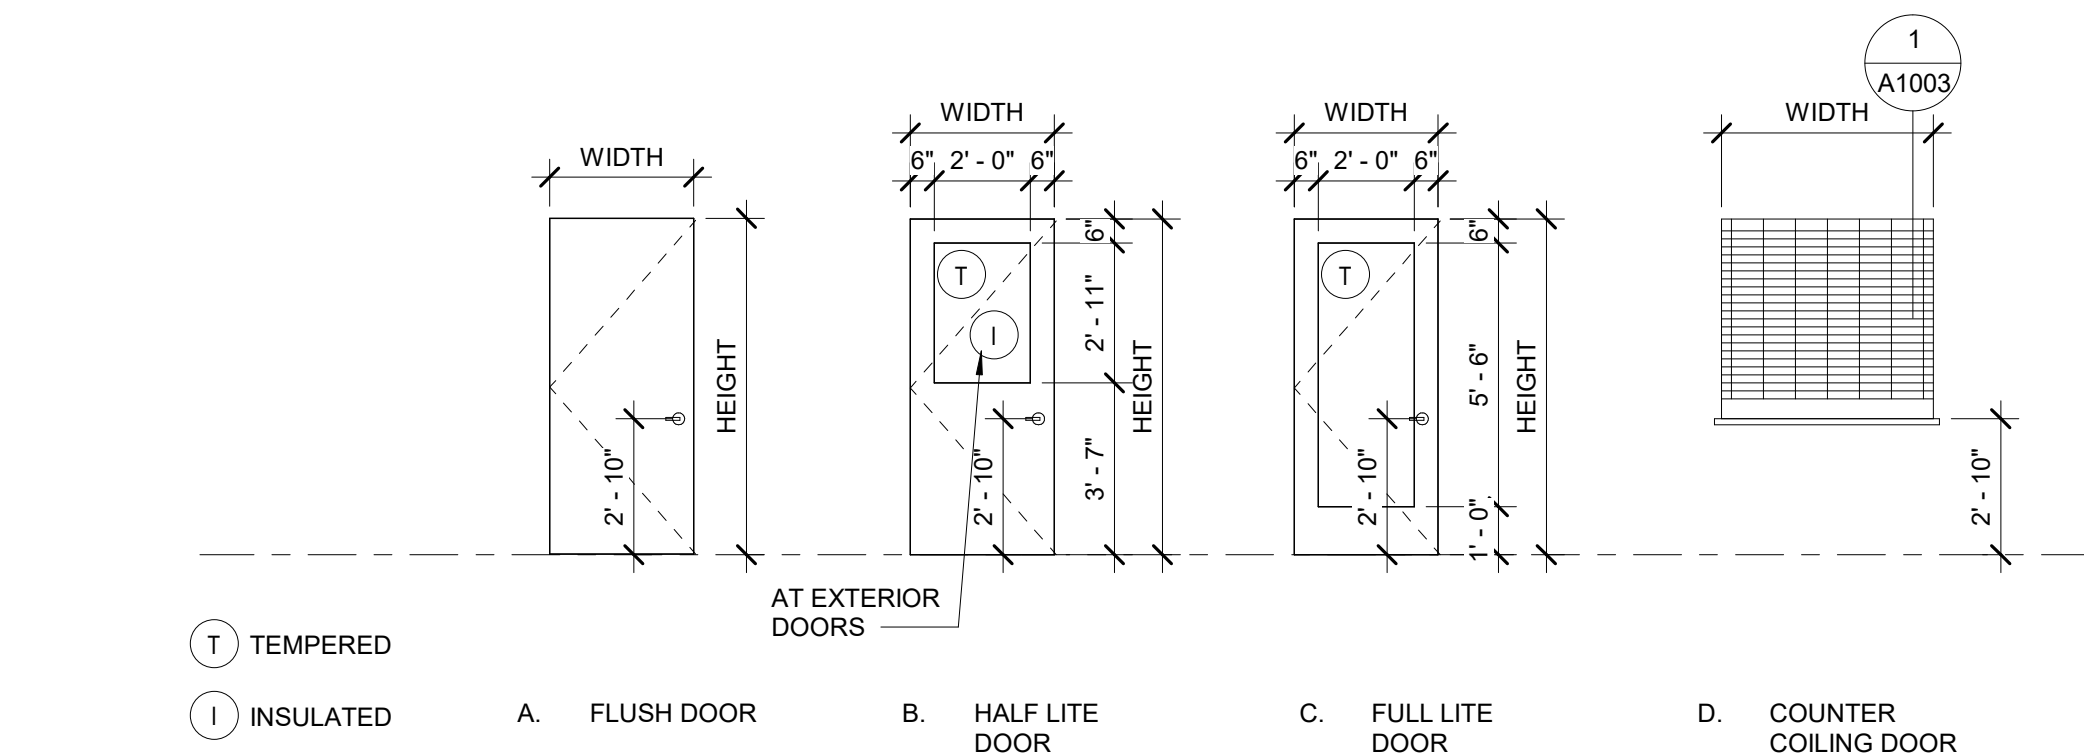


DOOR TYPES

1/4" = 1'-0"

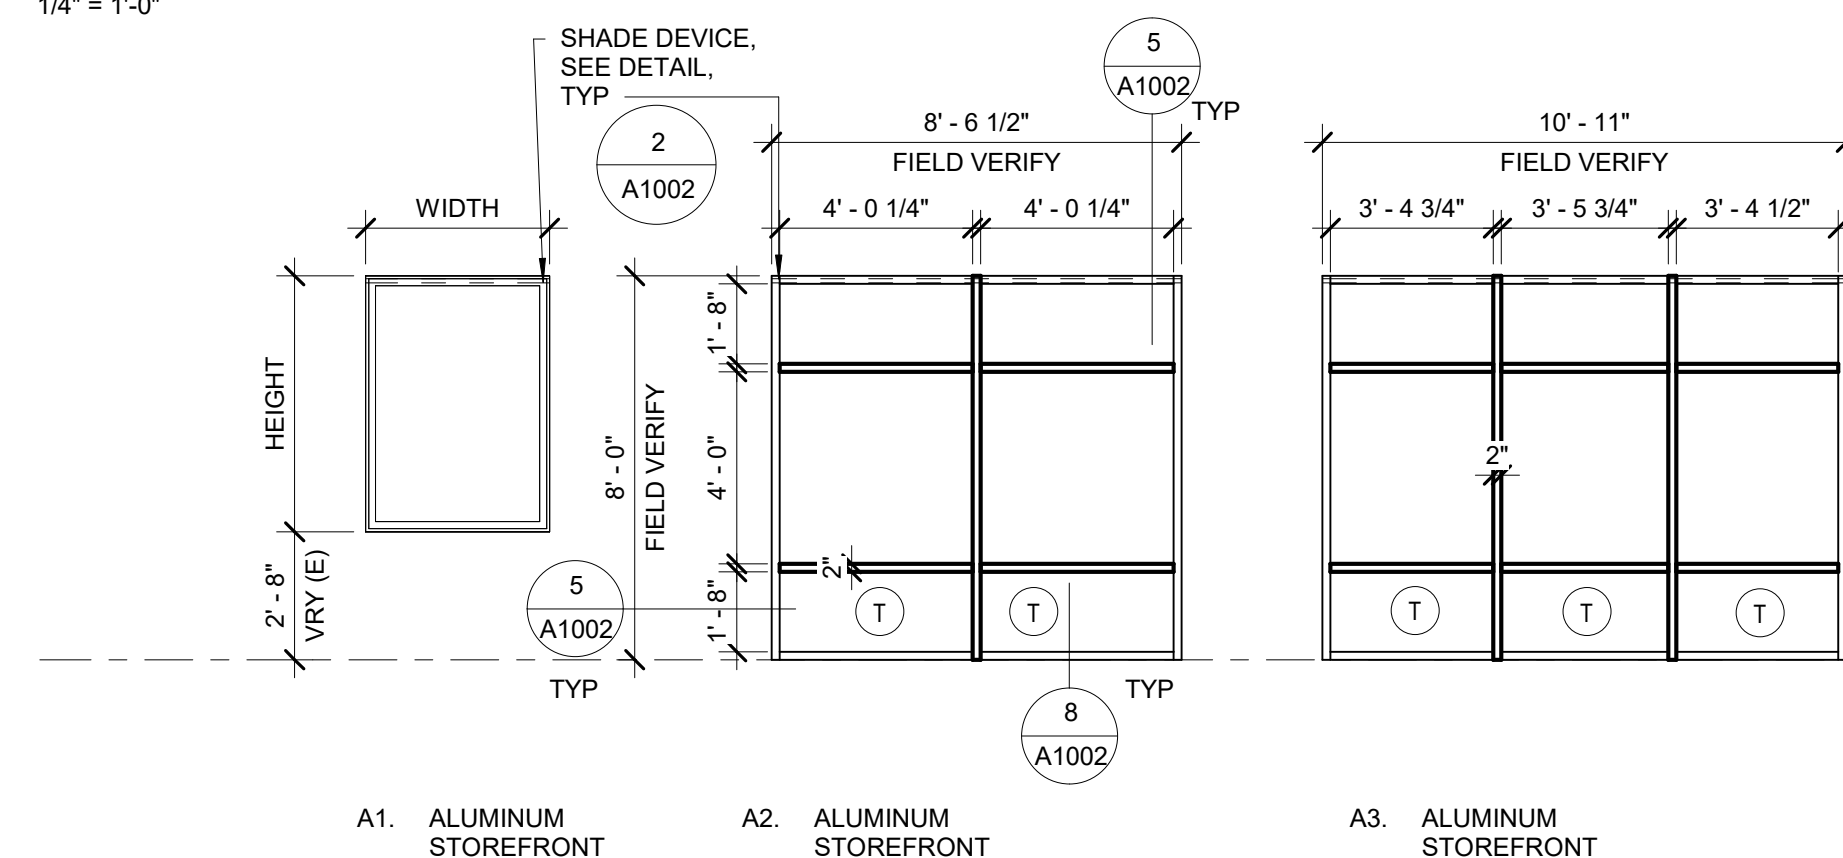

WINDOW TYPES

1/4" = 1'-0"


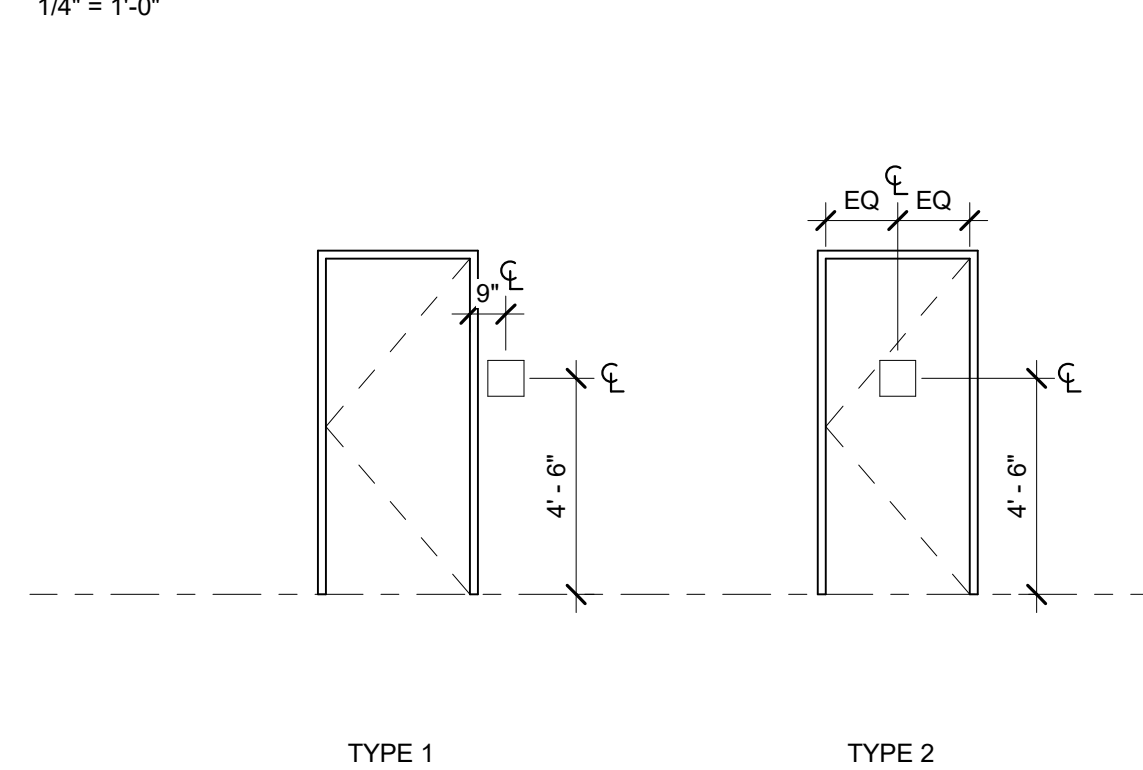


SIGNAGE MOUNTING TYPES

1/4" = 1'-0"

FRAME TYPES

1/4" = 1'-0"

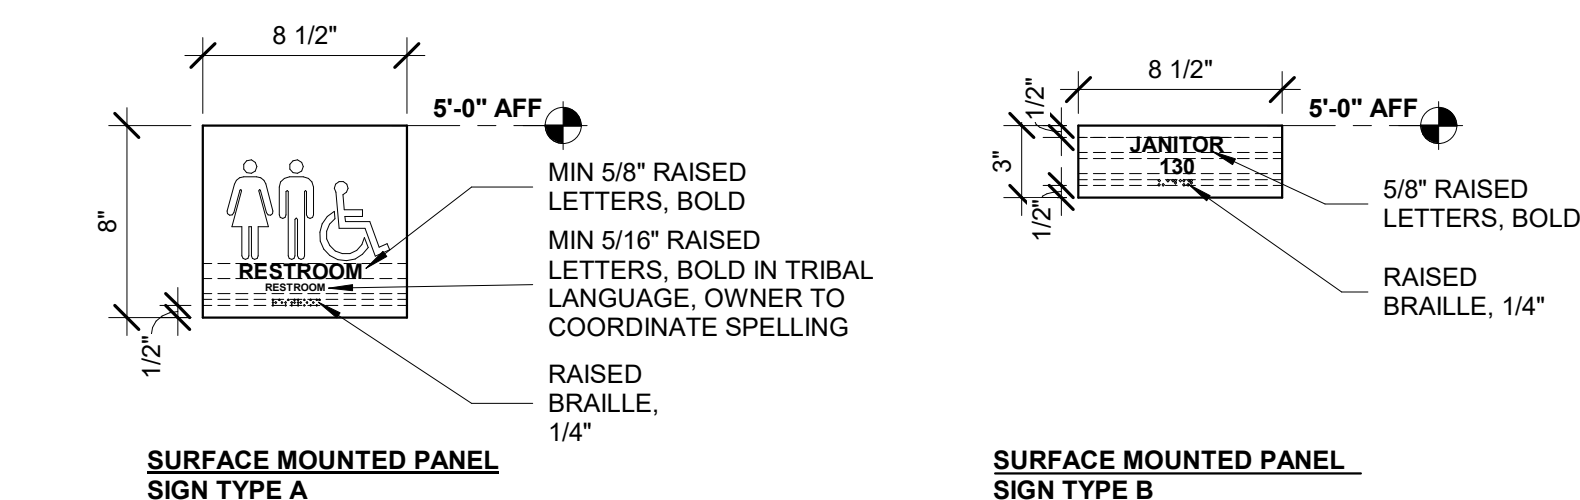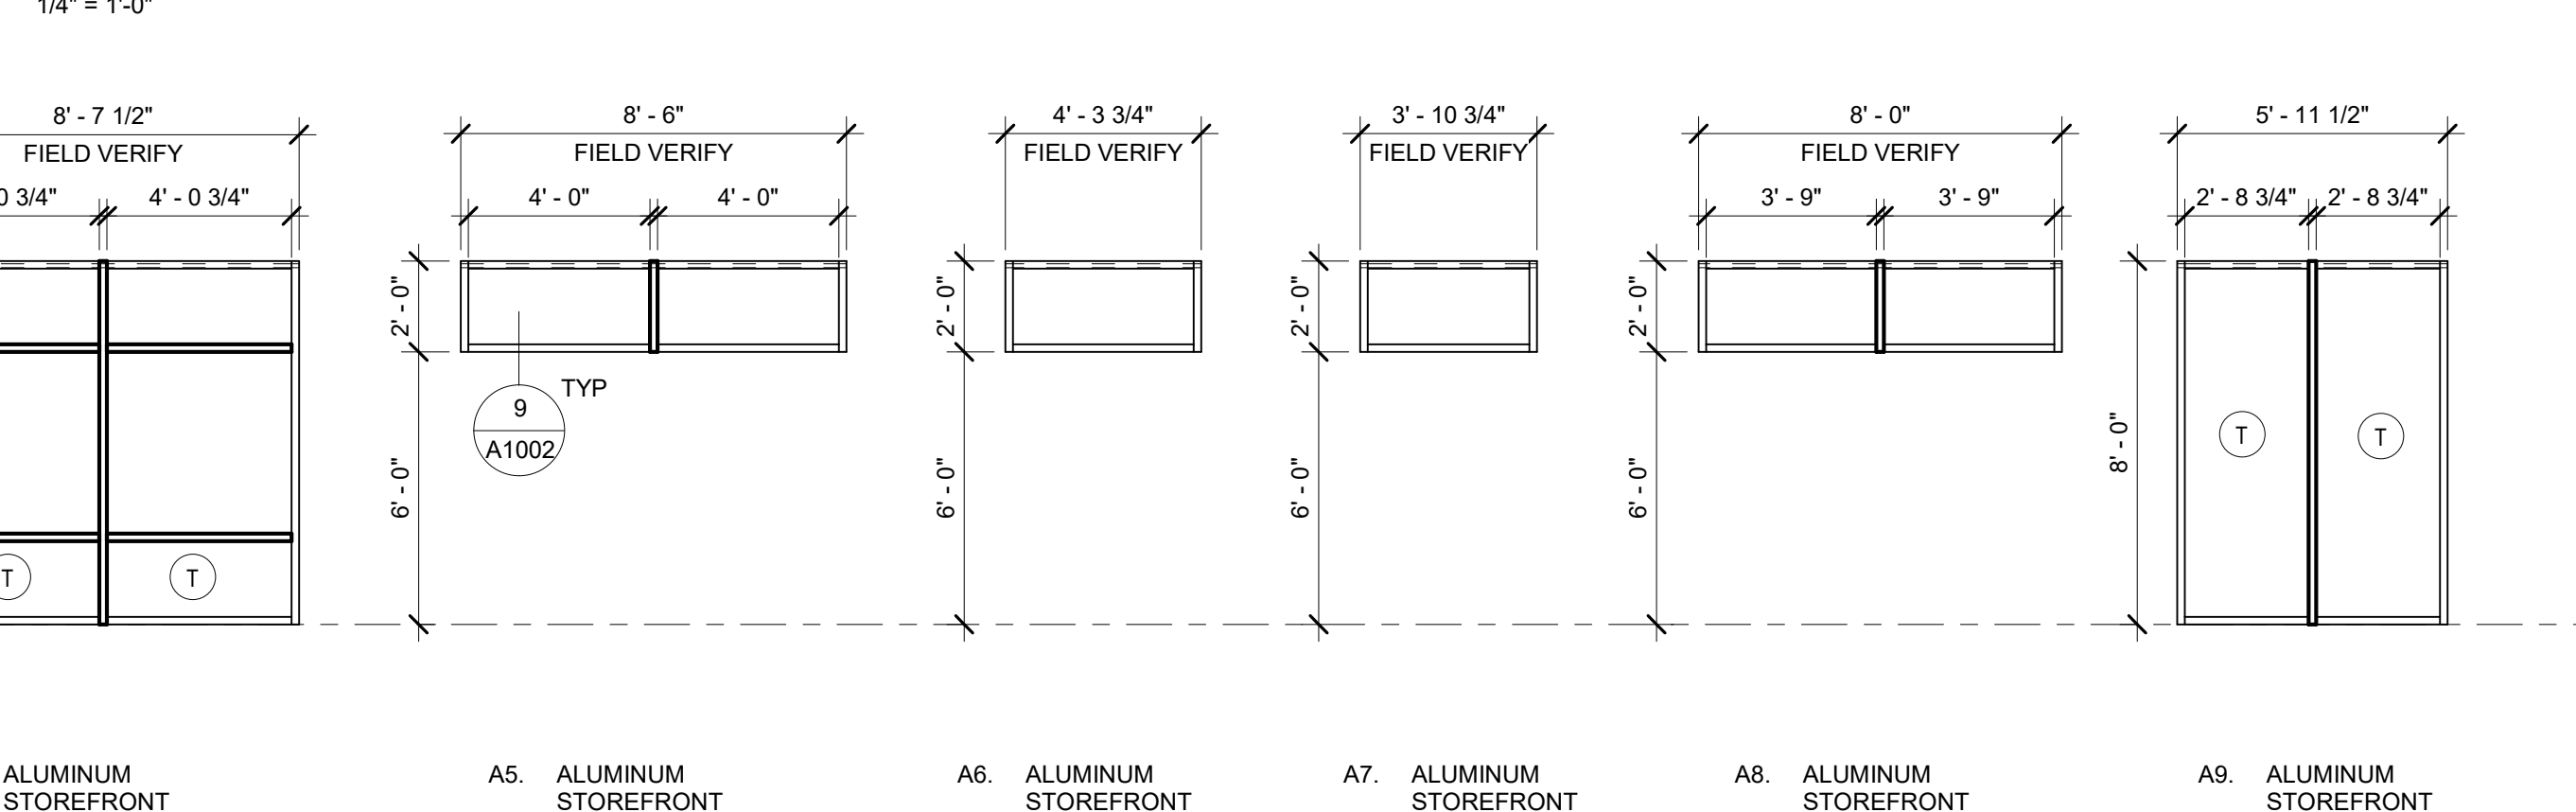


SIGNAGE TYPES

1 1/2" = 1'-0"

GENERAL NOTES:

- CONTRACTOR SHALL VERIFY WITH ARCHITECT PRIOR TO INSTALLATION WHICH SIDE OF DOOR SIGNAGE SHALL BE PLACED
- CONTRACTOR TO REVIEW AND VERIFY ALL ROOM NAMES AND SPELLING OF EACH SIGN BEFORE APPLICATION

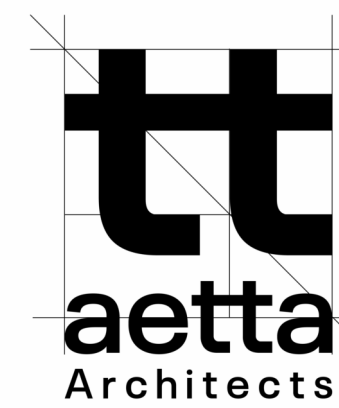

950 12th Avenue Suite 200
Longview, WA 98632
PH: 360-425-0000
www.aetta.com

8737 REGISTERED ARCHITECT
STEPHEN M. BLACK
STATE OF WASHINGTON

**COWLITZ INDIAN TRIBE
LONGVIEW PHARMACY**
1010 FIR STREET
LONGVIEW, WA 98632

PROJECT # 25065

DATE 05.19.2026

REVISIONS
NO. DATE DESCRIPTION
2 Date 2 REV 2

DOOR AND WINDOW SCHEDULES

A1001

BID SET